


# 3725 Beresford Road, Charlotte, North Carolina, 28211

3950.35 Total HSF

**Main Level**  
2985.45 Heated Living SF

**Upper Level**  
964.90 Heated SF

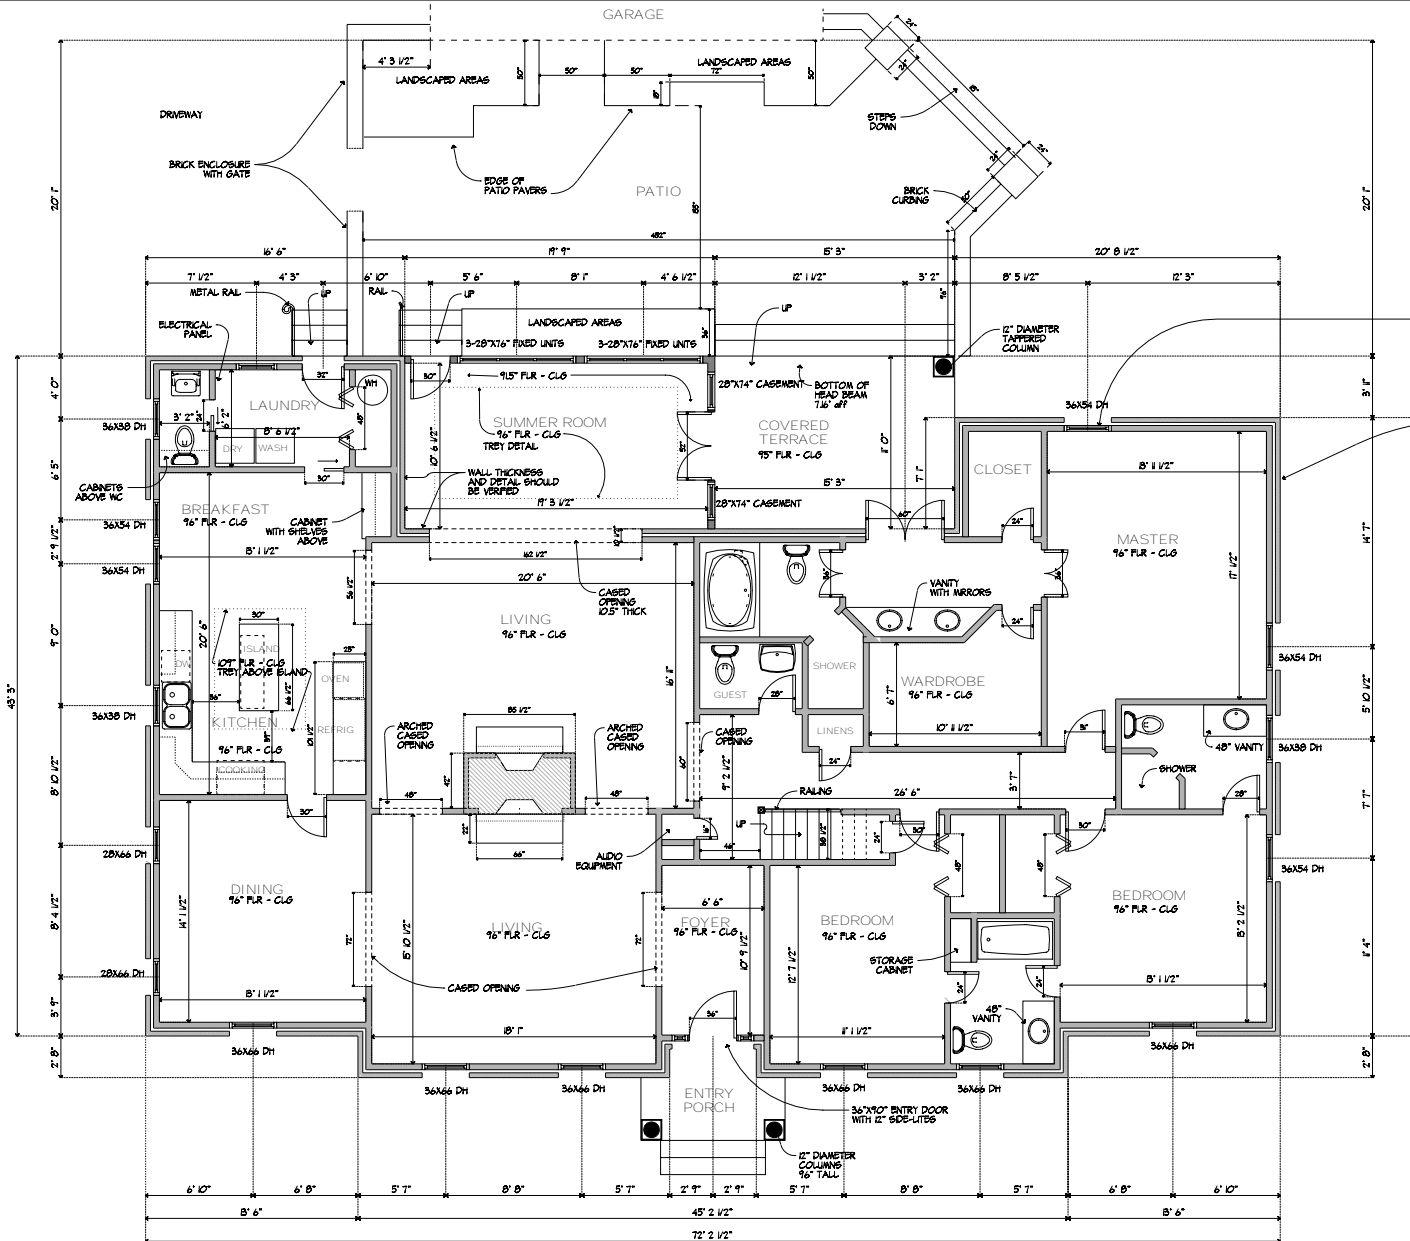

INTERIOR DOOR NOTE:  
ALL DOORS ARE STANDARD 80" HEIGHT,  
UNLESS NOTED OTHERWISE  
CASED OPENINGS ARE 80" CLEAR HEIGHT  
UNLESS NOTED OTHERWISE

ALL WINDOWS ARE AT  
TYPICAL 81" HEAD HEIGHT

BRICK EXTERIOR VENEER

